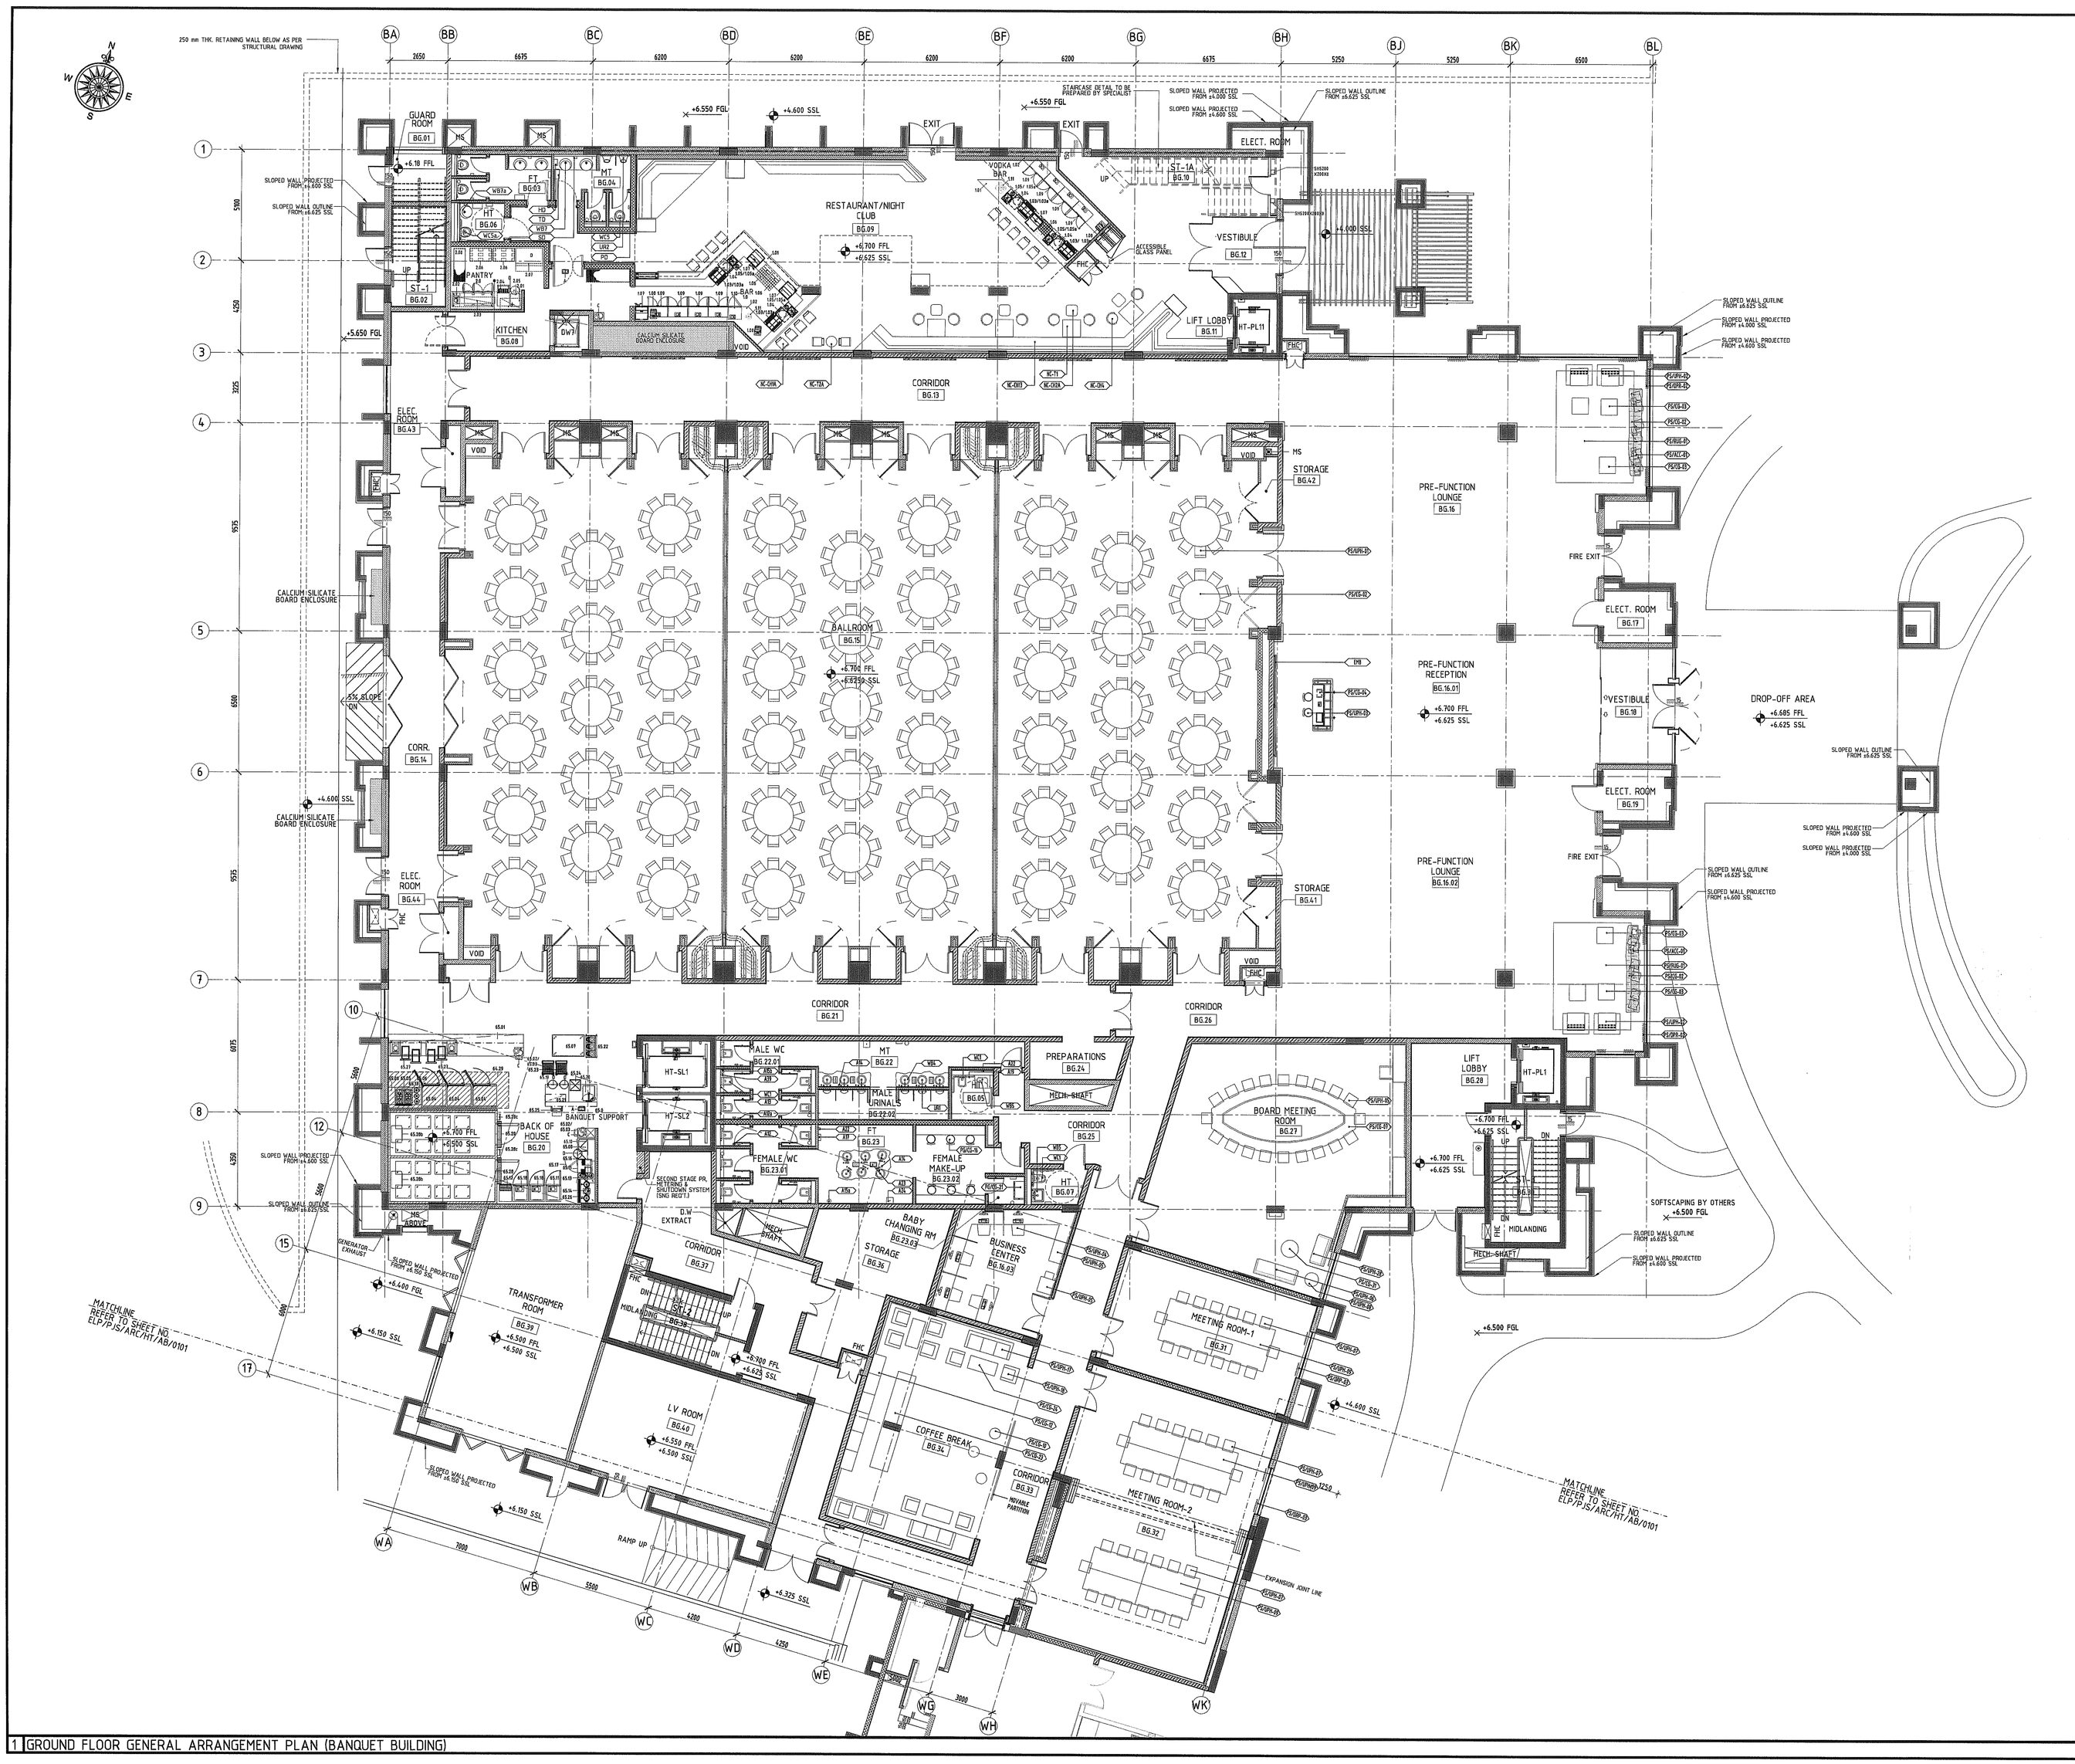

STANDARD EQUIPMENT SCHEDULE:

A. INSECT CONTROL UNIT
C. HAND WASH STATION
D. MOBILE REFUSE BIN
L. PRE RINSE UNIT

EQUIPMENT SCHEDULE:

1.0 BAR

1.01 FRONT BAR COUNTER BY I.D.
1.02 REAR BAR COUNTER BY I.D.
1.03 ICE CHEST
1.03a SPEED RAIL
1.04 BOTTLE BIN
1.05 BLENDER STATION
1.05a BLENDER
1.06 DRAUGHT BEER STATION
1.07 GLASS FROSTER
1.08 EPOS UNIT
1.09 UNDERCOUNTER BOTTLE COOLER
1.10 UNDERCOUNTER FREEZER
1.11 INSET WASH HAND STATION

2.0 PANTRY

2.01 WORK BENCH WITH OVERPASS SHELVES
2.02 3 DOOR UNDERCOUNTER REFRIGERATOR
2.03 HOT & COLD PASS
2.04 UNDERCOUNTER GLASS WASHER
2.05 SINK UNIT
2.06 PLASTIC DUNNAGE PALLET
2.07 ICE MACHINE
2.08 STORAGE SHELVING

65.0 BANQUET SUPPORT

65.01 HOT & COLD PASS COUNTER
65.02 HAND TOWEL DISPENSER
65.03 HAND TOWEL BIN
65.04 20 GRID COMBINATION OVEN
65.05 OPEN TOP RANGE & BURNER
65.06 WORKTOP
65.07 MOBILE WORK BENCH
65.08 WORK BENCH WITH SINK UNIT
65.09 OMITTED
65.10 WALL MOUNTED STORAGE CUPBOARD
65.11 UPRIGHT SINGLE DOOR REFRIGERATOR
65.12 ICE MACINE
65.13 WATER TREATMENT UNIT
65.14 COFFEE MACHINE (BULK BREWER)
65.15 MILK DISPENSER
65.16 WATER BOILER
65.17 UNDERCOUNTER REFRIGERATOR
65.18 UPRIGHT BOTTLE COOLER
65.19 DIRTIES SORTING BENCH
65.20 DOUBLE BOWL SINK UNIT
65.21 WALL MOUNTED BASKET SHELF
65.22 PLATE DOLLEY
65.23 BASKET DOLLEY
65.24 CUTLERY SOAK SINK
65.25 REFUSE SACK HOLDER
65.26 MOBILE WORK BENCH
65.27 2 DOOR UNDERCOUNTER REFRIGERATOR
65.28 MODULAR COLD ROOM
65.28a COMPRESSOR
65.28b EVAPORATOR
65.28c CONTROL PANEL
65.29 VENT CANOPY

FURNITURE LEGEND

FS/CG-01 FOLDING BANQUET TABLE
FS/CG-02 SECTIONAL LIZARD SHAPE SCULPTURAL BENCH
FS/CG-03 MARBLE TOP SIDE TABLE
FS/CG-04 DESK CHAIR
FS/CG-05 DESK
FS/CG-07 MEETING TABLE
FS/CG-09 SIDE TABLE
FS/CG-09 MEETING TABLE
FS/CG-10 STOOL
FS/CG-12 BUILT IN SOFA
FS/CG-13 CUSTOM MAKE UP CHAIR
FS/CG-13 PULL DOWN CHANGING TABLE
FS/CG-21 DESK
FS/CG-14 CENTER TABLE
FS/CG-31 CENTER TABLE
FS/CG-01 STACKABLE CHAIR
FS/GPH-01 WINGED ARMCHAIR
FS/GPH-04 DESK CHAIR
FS/GPH-05 MEETING CHAIR
FS/GPH-06 3 SEATER COUCH
FS/GPH-07 MEETING CHAIR
FS/GPH-07 3 SEATER SOFA
FS/GPH-08 SINGLE SEATER SOFA
FS/GPH-09 2 SEATER COUCH
FS/AC-01 DECORATIVE PILLOW
FS/GBP-01 WINDOW TREATMENT FABRICATION
FS/GBP-02 WINDOW TREATMENT FABRICATION
FS/GBP-03 WINDOW TREATMENT FABRICATION
FS/RUG-01 AREA RUG
EMB ELECTRONIC MESSAGE BOARD
KC-CH06 HIGH STOOL
KC-CH02 POUF OTTOMAN
KC-CH01 LOW CHAIR
KC-CH03 BESPOKE SEATING WITH COWHIDE LEADER (DARK)
KC-T1 LOW TABLE

ACCESSORIES LEGEND

A12 TOILET PAPER HOLDER
A12a EXTRA TOILET PAPER HOLDER
A13 HOOK
A14 TOP MOUNTED LIQUID SOAP & HAND LOTION
A14a WALL MOUNTED LIQUID SOAP & HAND LOTION
A15a WASTE BIN (SL)
A15b WASTE BIN (SL)
A17 WALL MOUNTED TISSUE PAPER DISPENSER
A18 WALL MOUNTED SANITARY BAG DISPENSER
A19 DISABLE GRAB BAR
A20 WALL MOUNTED URINAL DIVIDER
A22 WALL MOUNTED AIRFRESH DISPENSER
A23 HAND DRYING TOWEL TRAY
A24 HAND DRYING TOWEL DISPOSAL BASKET
A39 WALL MOUNTED TOILET BRUSH
WC1 WALL MOUNTED WC, MOUNTING ELEMENT & ABLUTION SPRAY
WC2 FLOOR TO WALL WC, MOUNTING ELEMENT & ABLUTION SPRAY
WB4 OVER MOUNT SINK & SINK SPOUT
WC5 DISABLED WASH BASIN & SINK SPOUT
UR1 WALL MOUNTED URINAL
WB WASH BASIN
WC WATER CLOSET
UR URINAL
HD HAND DRIER
TD TISSUE DISPENSER
SD SOAP DISPENSER
PD PAPER DISPENSER

LEGEND:

SYMBOL	DESCRIPTION
	DISTRIBUTION BOARD
	SUB MAIN DISTRIBUTION BOARD
	SHAFT SLAB OPENING
	SHAFT SLAB SLEEVE ZONE

1 GROUND FLOOR GENERAL ARRANGEMENT PLAN (BANQUET BUILDING)

SCALE 1:100

PROJECT NAME:

PALM JUMEIRAH SOFITEL RESORT

PARCEL NO. PJCRC28 & 29

CLIENT:

M/s SAHRA FZCO JOINTLY WITH M/s SHAMS AL SAHRA FZCO

CONSULTANT:

MIRK Architectural & Engineering
Tel: +971 4 455 8100, Fax: +971 4 455 8404, Email: mirkae@emirates.net

KEY PLAN:

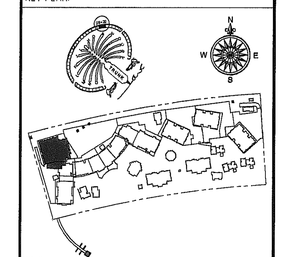

AS BUILT REFERENCE

DWG. TITLE	DRAW. NO.
GROUND FLOOR GENERAL ARRANGEMENT PLAN (BANQUET BUILDING)	0670201/STS-00200-137 REV.06
HOTEL BUILDING GROUND FLOOR BALLROOM DORMA HUPPE MOVABLE WALL PANEL LAYOUT	0670201/STS-00200-1122 REV.01

REFERENCE		
0670201/RFI NO.:	MIRK TRN/ LTR	CVI/ EI
RFI-638, 1522	TRN-996	
RFI-645, 1142	TRN-927	
	TM-020	
	TM-012	

RECEIVED 13 MAY 2013 EVAN LIM-PENTA CONSTRUCTION CO.LLC

STATUS OF ACTION BY ENGINEER

☑ APP - APPROVED
☐ NA - REJECTED, NOT APPROVED

ENGINEER'S SIGNATURE — DATE 12/05/13

NOTES:

AS BUILT

NO.	DATE	DESCRIPTION	BY	CHKD	APPR
01	27/04/13	FOR APPROVAL		WW	LWK
00	22/10/12	FOR APPROVAL	ADC	WW	LWK

REVISION HISTORY.

CONTRACTOR:

EVAN LIM - PENTA CONSTRUCTION CO. LLC
P. O. Box 80255, Dubai, UAE
Tel. +971 4 2976988 Fax: +971 4 2976366
Email: elp_co@elm.ae

RECEIVED 05 MAY 2013 EVAN LIM-PENTA CONSTRUCTION CO.LLC

TRANSMITTAL NO.:

0670201/STS-08000-072 REV.01

DRAWING TITLE:

BANQUET BUILDING
GROUND FLOOR GENERAL ARRANGEMENT PLAN
AS BUILT DRAWING

ELP VERIFIED

Status	
Name	KD
Signature	

DRAWING NO.	REV.
ELP/PJS/ARC/BQ/AB/0101	01

SCALE	DATE	SHEET
1:100	27APRIL2013	A0

Prepared By	Drawn By	Checked By	Approved By
	MC	WW	LWK